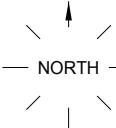
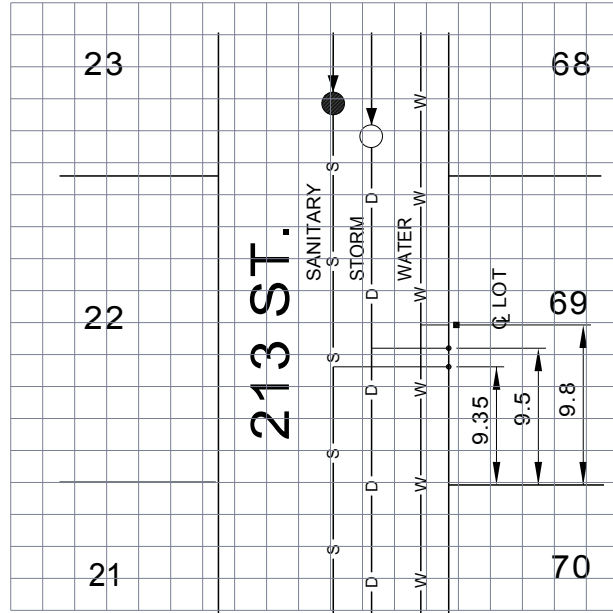


8"

5"

 <p>Township of Langley SERVICE RECORD CARD</p>	Address		Project #	
	6907 - 213 ST.		8-13-10	
 <p>(SKETCH PLAN)</p>	Type of Building	Lot No.	Roll No.	
	S.F.D.	69	BY TWP	
	WATER	AS-BUILT DATE		
		MARCH 30, 1996		
		SIZE & TYPE		
		20mm ø POLY TUBING		
	METER			
	N/A			
	LOCATION TO RL			
	9.8m NORTH OF SOUTHWEST CORNER OF PROPERTY			
SANITARY	AS-BUILT DATE			
	MARCH 29, 1996			
	SIZE & TYPE			
	100mm ø PVC			
LOCATION TO RL				
9.35m NORTH OF SOUTHWEST CORNER OF PROPERTY				
DEPTH				
1.4m				
STORM	AS-BUILT DATE			
	MARCH 29, 1996			
	SIZE & TYPE			
	150mm ø PVC			
LOCATION TO RL				
9.5m NORTH OF SOUTHWEST CORNER OF PROPERTY				
DEPTH				
1.45m				

NOTE:

1) SERVICE CARDS SHALL BE ACCEPTED ON 65lb (270gsm) WHITE CARD STOCK ONLY.

TITLE


SAMPLE SERVICE RECORD CARD



THE CORPORATION OF THE TOWNSHIP OF LANGLEY

DATE	REV. JAN./09
APPROVED	
S.C.B.No.	SCBE0019 (OLD #)

TLG 2

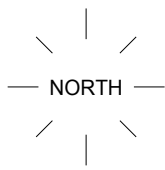


Township of Langley

SERVICE RECORD CARD

(SKETCH PLAN)

Address		Project #
Type of Building	Lot No.	Roll No.
W A T E R	AS-BUILT DATE	
	SIZE & TYPE	
	METER	
	LOCATION TO R _L	
S A N I T A R Y	AS-BUILT DATE	
	SIZE & TYPE	
	LOCATION TO R _L	
	DEPTH	
S T O R M	AS-BUILT DATE	
	SIZE & TYPE	
	LOCATION TO R _L	
	DEPTH	

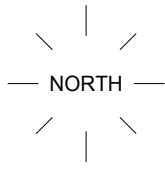

Township of Langley

SERVICE RECORD CARD

(SKETCH PLAN)

Address		Project #
Type of Building	Lot No.	Roll No.
W A T E R	AS-BUILT DATE	
	SIZE & TYPE	
	METER	
	LOCATION TO R _L	
S A N I T A R Y	AS-BUILT DATE	
	SIZE & TYPE	
	LOCATION TO R _L	
	DEPTH	
S T O R M	AS-BUILT DATE	
	SIZE & TYPE	
	LOCATION TO R _L	
	DEPTH	